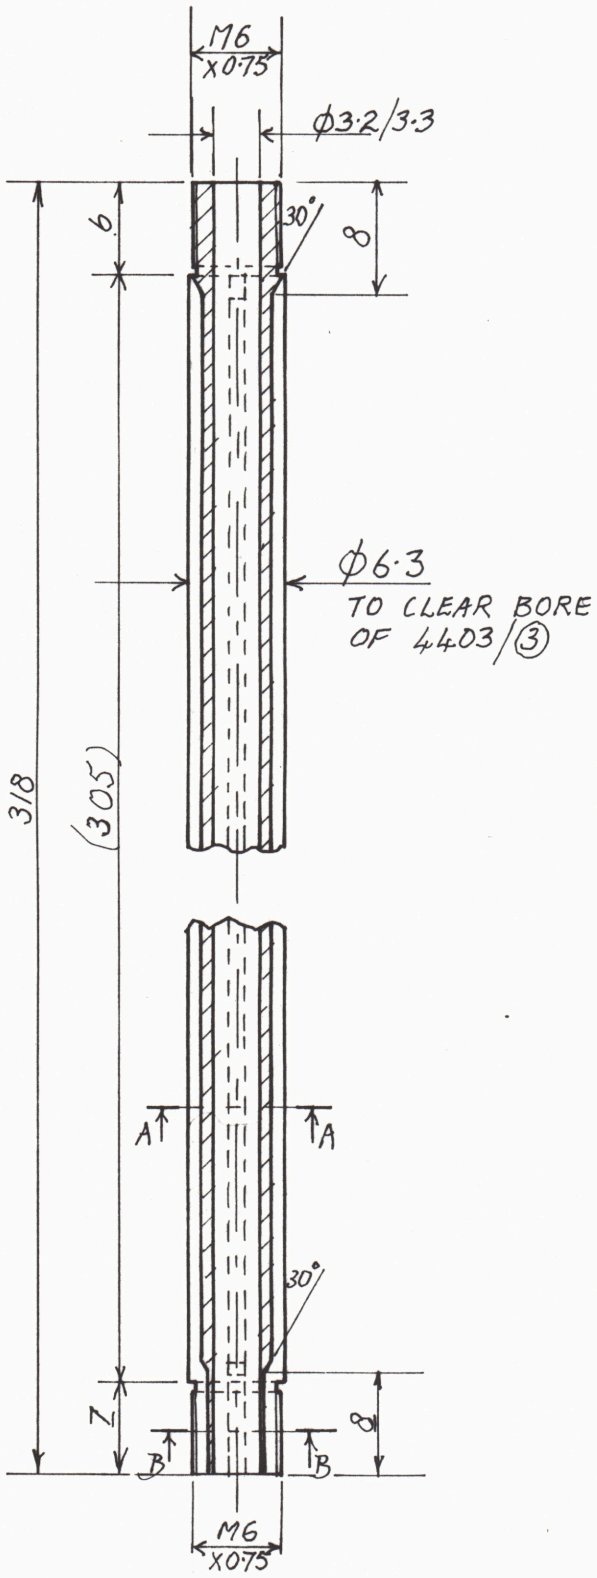

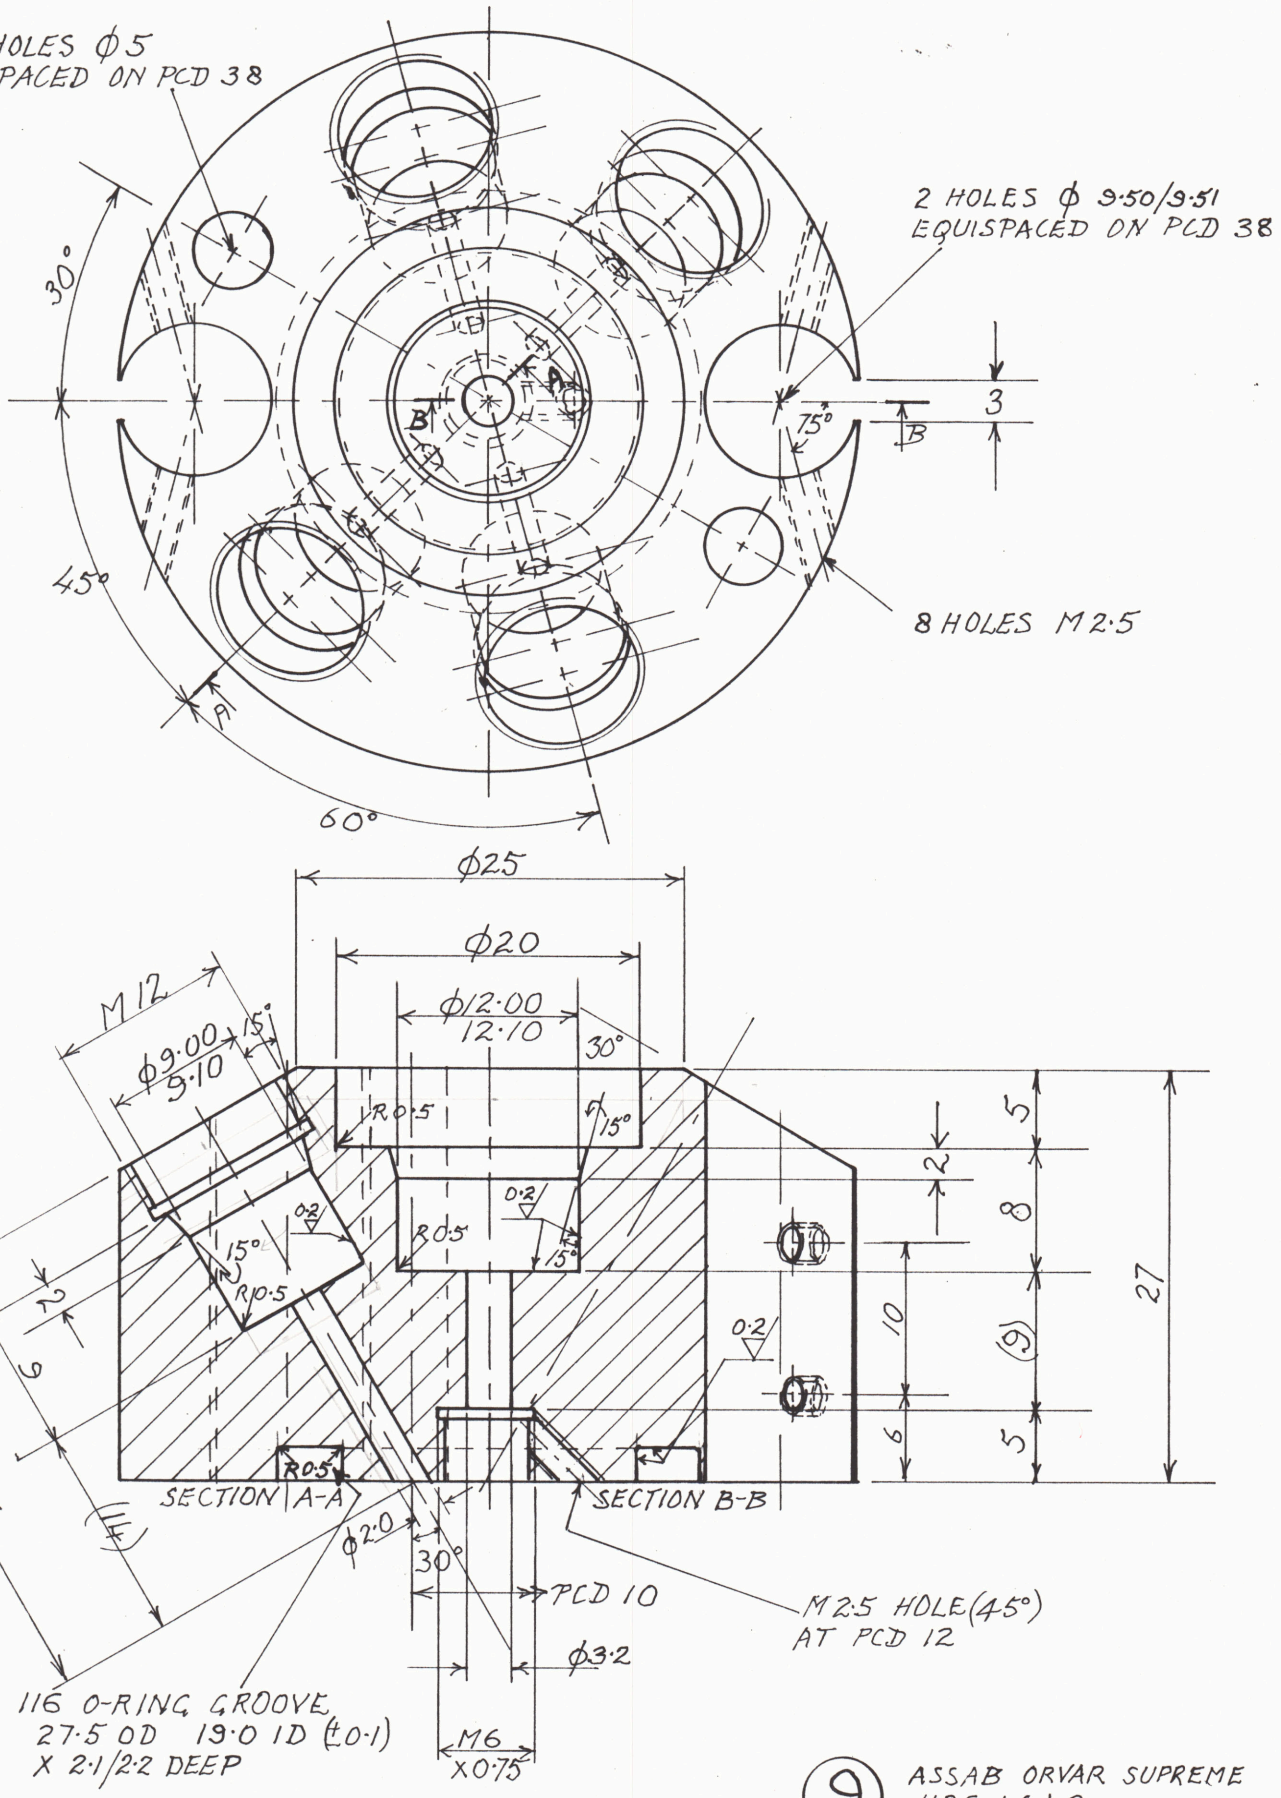

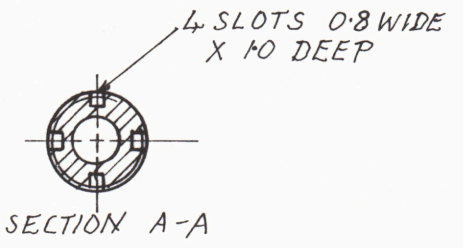

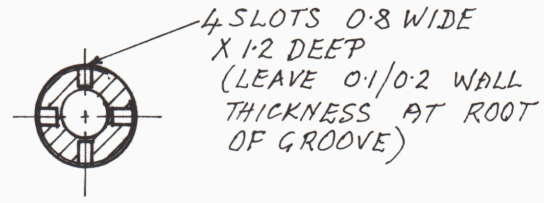

⑨ ASSAB ORVAR SUPREME
HRC 46±2

⑩ STEEL SUCH AS
SS TUBING 6·35 OD X 1·6 WT

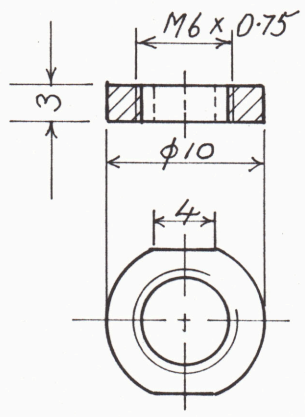

~~10~~ 10A

⑪ ASSAB 709
OR SIMILAR

NOTE: WHEN INSTALLING LEADS, FIX WITH EPOXY UNDER THREADS & FINALLY CLEAR THREADS

DIMENSIONS IN MILLIMETRES
DO NOT SCALE

TOLERANCES ± 0·3 UNLESS STATED

ACN 008 644 273

PATERSON INSTRUMENTS PTY LTD

HPT TESTING MACHINE
PRESSURE VESSEL ASSEMBLY
STRAIN GAUGE LOAD CELL - DETAILS ⑨ - ~~10~~ ⑪

A3	SCALE 2:1	DATE APR 1996	DRAWING NO 4405